

DISCLOSURE PLAN
FOR PROPOSED LOT 8

Currently described as
Lot 98 on S312680


Scale: 1:500 at A3
Datum: AHD
Origin: PM108348
Locality: New Beith
LGA: Logan C.C.
Cadfile: QMP-302_DIS_B

B	Lots 11 & 12 Boundaries Amended Final Contours and Cut/Fill	CS	22.09.23	MP
A	ORIGINAL ISSUE	CS	23.02.23	MP
Issue	Description	Drw	Date	Appd

- NOTES**
- This plan shows details of Proposed Lot 8 on the Concept Plan 8590 P 09 Rev J - STG 01 by Saunders Havill Group which accompanied the subdivision application and was approved by Logan City Council on 29/06/2023, subject to conditions.
 - Areas and dimensions are subject to final survey and plan registration.
 - Natural surface contours have been derived from field survey by Focus on Surveying.
 - As-Constructed contours have been derived from field survey by Focus on Surveying.
 - The compaction of the fill will be done in accordance with Australian Standard AS3798-2007 Level 1 inspection and testing will be carried out on fill over 0.3m.

LEGEND

Natural Contours	-- 5.0 --
As-Constructed Contours	— 4.0 —
Depth of Fill	+0.2
Extent of Fill Area	
Extent of Cut Area	

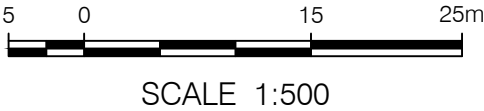

FOCUS
ON SURVEYING

www.focussurvey.com.au
info@focussurvey.com.au ph 3338 5095
Suite 6, 214 Waterworks Road . Ashgrove . QLD . 4060
Unit 4b, 115a Point Cartwright Drive . Buddina . 4575